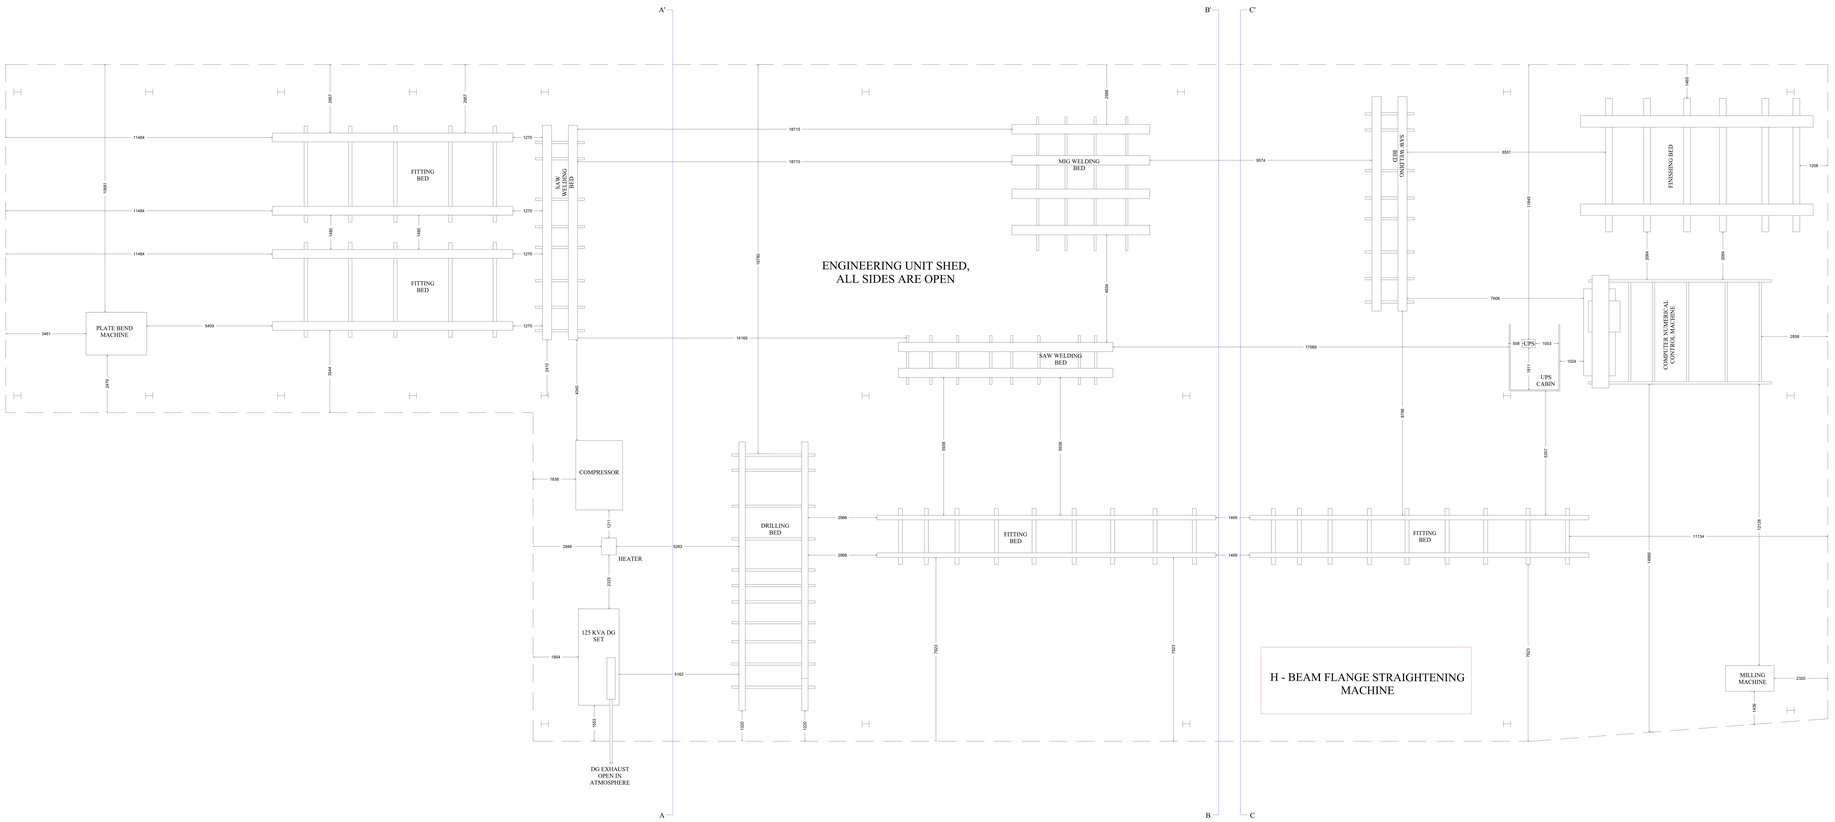

PLAN OF ENGINEERING UNIT, WELDING, COMPRESSOR, FITTING & LAYOUT BED SHED, ALL SIDES ARE OPEN, AS PER SITE PLAN ITEM NUMBER 1
SCALE 1:1000

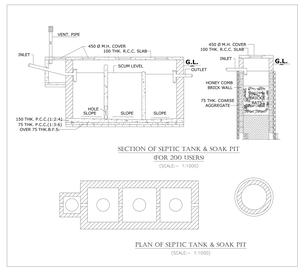

SECTION OF SEPTIC TANK & SOAK PIT
(FOR 200 USERS)
(SCALE:- 1:1000)

PLAN OF SEPTIC TANK & SOAK PIT
(SCALE:- 1:1000)

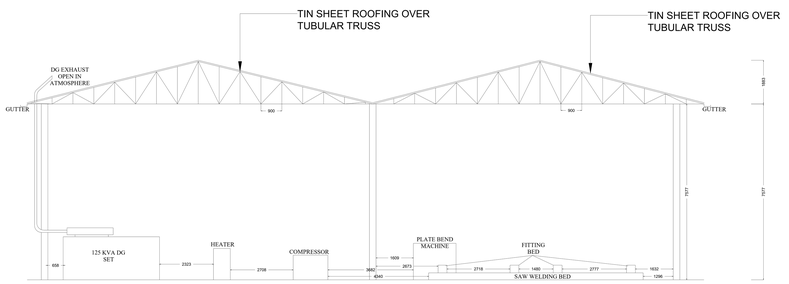

SECTION A-A'
SCALE 1:1000

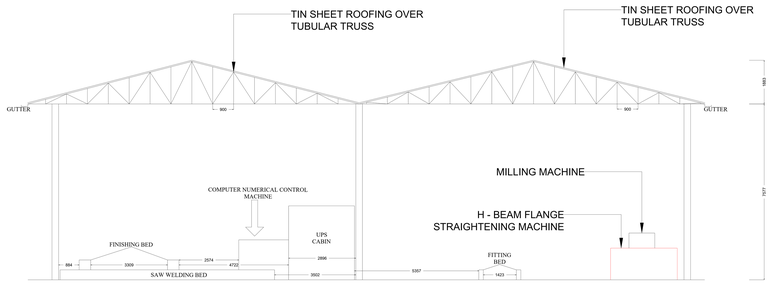

SECTION C-C'
SCALE 1:1000

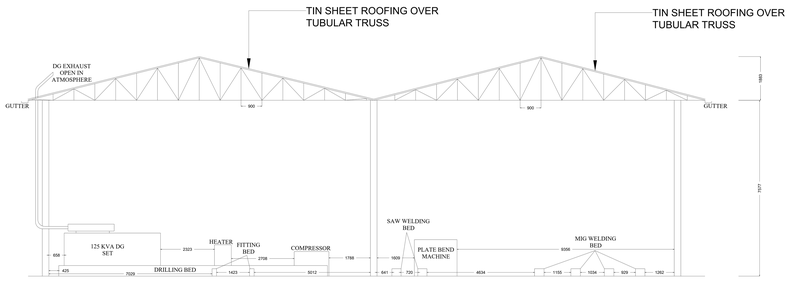

SECTION B-B'
SCALE 1:1000

NOTES:

1.... Total nos of workers including office staff - 85 Nos (Male only)
2.... ALL DIMENSIONS ARE IN mm. UNLESS OTHERWISE MENTIONED.
3.... Total no of latrine and urinal :
For male : Latrine 4 nos, Urinal 4 nos.
4.... All doors & windows are opening outwards.
5.... POSITION OF FIRST AID, FIRE FIGHTING ARRANGEMENT SHALL BE PROVIDED & MAINTAINED AS PER THE FACTORY ACT 1948, & RULES FRAMED THERE UNDER.
6.... SECTION CUT LINE SHOWN IN BLUE COLOR
7.... BOUNDARY SHOWN IN GREEN COLOR.
8.... FIRE WATER PIPE LINE SHOWN IN
9.... EXTENSION SHOWN IN RED COLOR.
10.. DEMOLISHED STRUCTURE SHOWN THUS

SILL HEIGHT = 900 mm

MAIN ENTRANCE DOOR = 6000 x 4500 (IRON)
MANY SMALL WINDOWS & VENTILATORS ARE COVERED WITH NET & GLASS

NAME OF THE OCCUPIER :

SIGNATURE OF THE OCCUPIER:

DATE: 29.11.2025

PROJECT : FACTORY MANUFACTURING OF FABRICATION & ENGINEERING

FACTORY PLAN OF
BRBA INFRATECH LLP

TITLE : PLAN OF ENGINEERING UNIT SHED

ADDRESS : PANBARI, P.O & P.S - ALIPURDUAR,
DISTRICT - ALIPURDUAR, WESTBENGAL, PIN - 736121

PREVIOUS APPROVAL PLAN NUMBER: 1947
DATE: 24/07/2024

DATE: 29.11.2025

SCALE : 1:1000

SHEET NO: 3 OF 5

STALK HEIGHT OF DG & CHIMNEY AS PER W.B.P.C.B. NORMS

C.N.C. - COMPUTER NUMERICAL CONTROL

S.A.W. - SUBMERGED ARC WELDING

M.I.G. -METAL INERT GAS

APPROPRIATE RUBBER INSULATION MAT ARRANGEMENT IN FRONT OF ALL ELECTRICAL PANEL & ENGINE & DG ROOM.

LIQUEFIED PETROLEUM GAS DETECTING SENSOR & ALARM ARRANGEMENT INSTALLED IN ALL VULNERABLE ZONE.