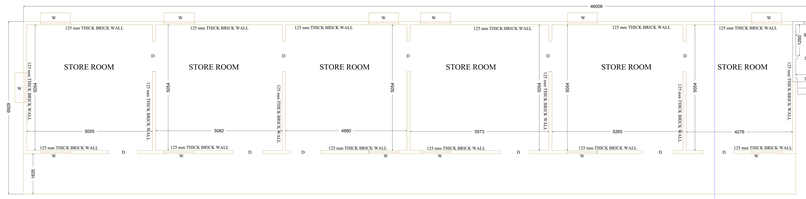

PLAN OF STORE ROOM, IN SITE PLAN SHOWN IN DEMOLISHED STRUCTURE
SCALE 1:1000

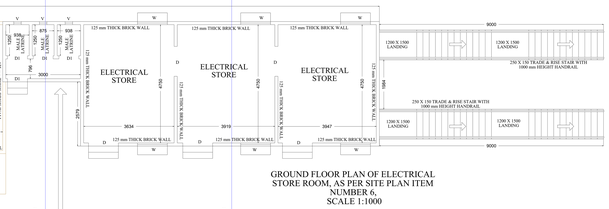

GROUND FLOOR PLAN OF ELECTRICAL STORE ROOM, AS PER SITE PLAN ITEM NUMBER 6,
SCALE 1:1000

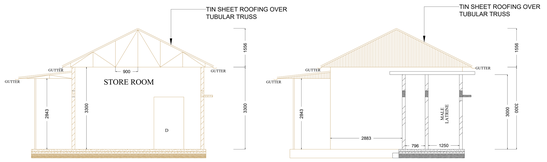

SECTION D-D'
SCALE 1:1000

SECTION E-E'
SCALE 1:1000

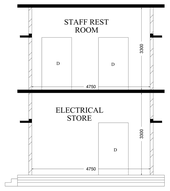

SECTION F-F', F1-F'1
SCALE 1:1000

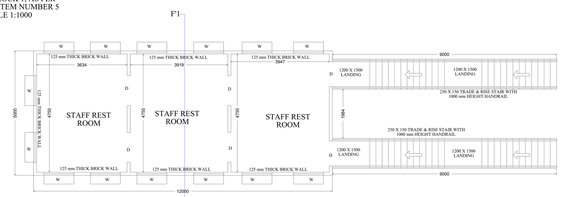

FIRST FLOOR PLAN OF STAFF REST ROOM, AS PER SITE PLAN ITEM NUMBER 6
SCALE 1:1000

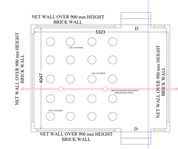

PLAN OF LIQUEFIED PETROLEUM GAS BANK, AS PER SITE PLAN ITEM NUMBER 3
SCALE 1:1000

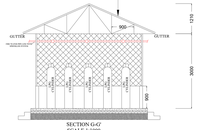

SECTION G-G'
SCALE 1:1000

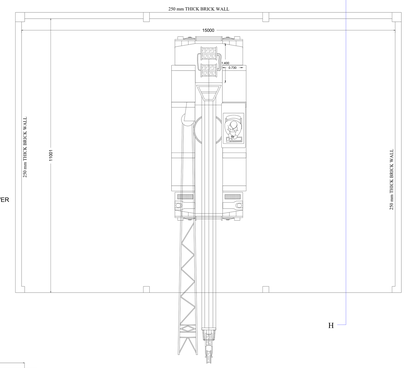

PLAN OF VEHICLE GARAGE SHED ONE SIDE OPEN, AS PER SITE PLAN ITEM NUMBER 13
SCALE 1:1000

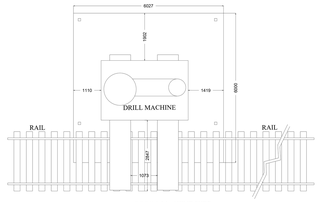

PLAN OF DRILL MACHINE SHED
SCALE 1:1000

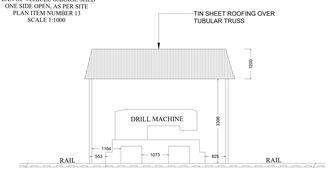

FRONT ELEVATION OF DRILL MACHINE SHED, AS PER SITE PLAN ITEM NUMBER 9
SCALE 1:1000

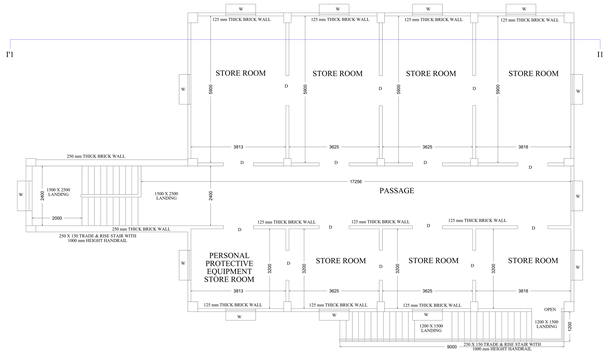

FIRST FLOOR PLAN OF STORE ROOM & PERSONAL PROTECTIVE EQUIPMENT STORE ROOM, AS PER SITE PLAN ITEM NUMBER 11
SCALE 1:1000

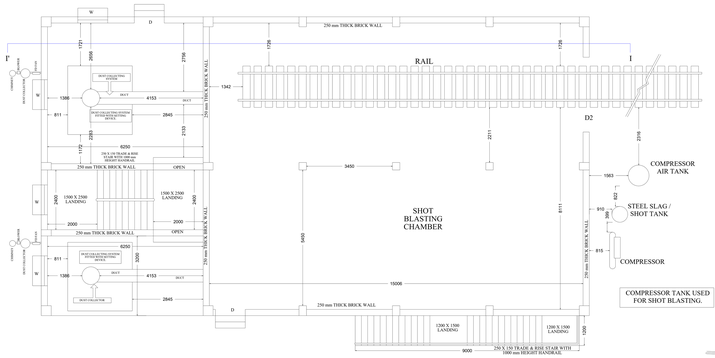

GROUND FLOOR PLAN OF SHOT BLASTING CHAMBER, AS PER SITE PLAN ITEM NUMBER 11
SCALE 1:1000

COMPRESSOR TANK USED FOR SHOT BLASTING.

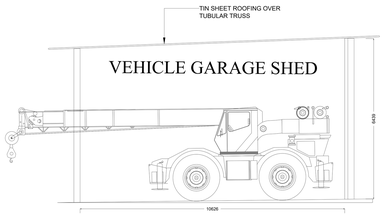

SECTION H-H'
SCALE 1:1000

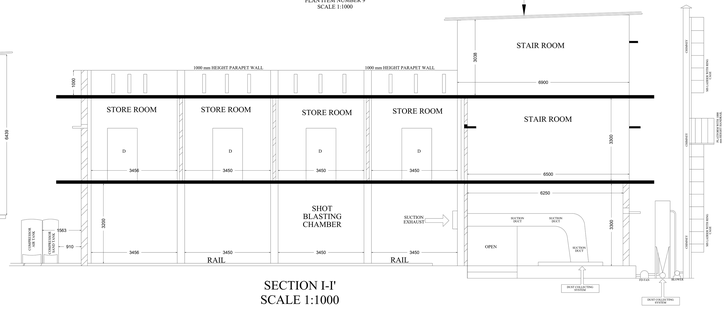

SECTION I-I'
SCALE 1:1000

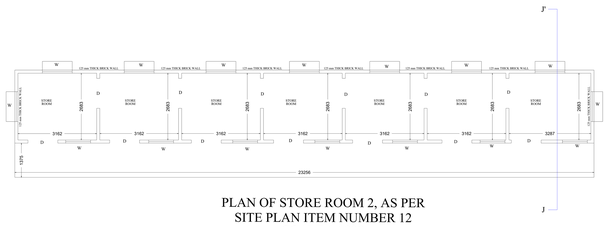

PLAN OF STORE ROOM 2, AS PER SITE PLAN ITEM NUMBER 12
SCALE 1:1000

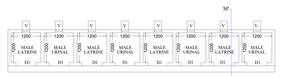

PLAN OF MALE LATRINE & URINAL BLOCK 2, AS PER SITE PLAN ITEM NUMBER 10
SCALE 1:1000

FRONT ELEVATION OF MALE LATRINE & URINAL BLOCK 2, AS PER SITE PLAN ITEM NUMBER 10
SCALE 1:1000

SECTION L-L', L1-L'1
SCALE - 1:1000

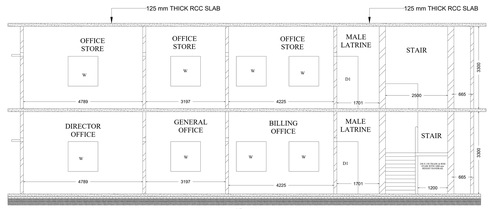

SECTION K-K', K1-K'1
SCALE - 1:1000

SCHEDULE OF DOOR & WINDOW			
SIGN	WIDTH	HEIGHT	SILL HEIGHT
W	1200	1200	900
W1	2000	1200	900
V	300	150	2350
D	1200	2100	-
D1	800	2100	-
D2	3000	2300	-

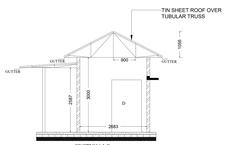

SECTION J-J'
SCALE - 1:1000

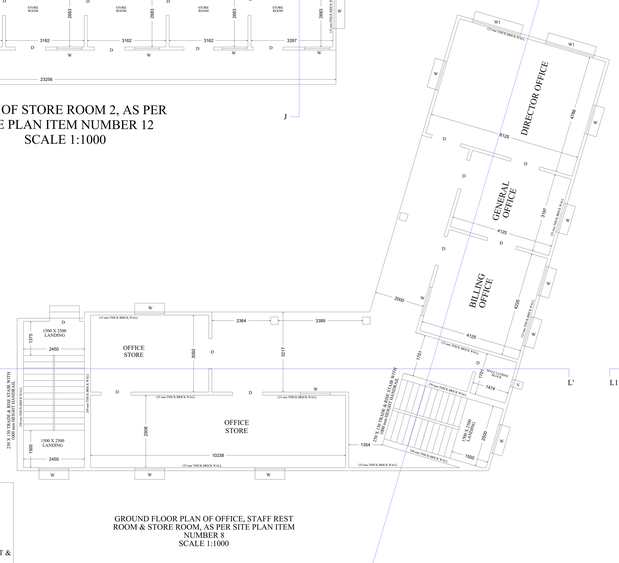

GROUND FLOOR PLAN OF OFFICE, STAFF REST ROOM & STORE ROOM, AS PER SITE PLAN ITEM NUMBER 8
SCALE 1:1000

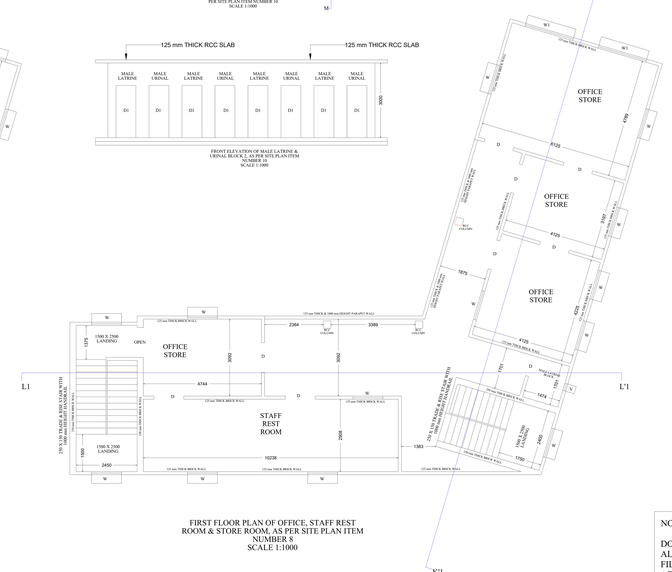

FIRST FLOOR PLAN OF OFFICE, STAFF REST ROOM & STORE ROOM, AS PER SITE PLAN ITEM NUMBER 8
SCALE 1:1000

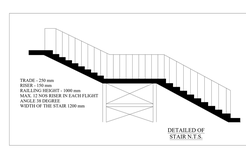

DETAILED OF STAIR N.T.S.

NOTES:

1.. Total nos of workers including office staff - 85 Nos (Male only)
2.. ALL DIMENSIONS ARE IN mm. UNLESS OTHERWISE MENTIONED.
3.. Total no of latrine and urinal
 For male : Latrine 4 nos, Urinal 4 nos.
4.. Total no of water tap provided for towards.
5.. POSITION OF FIRST AID, FIRE FIGHTING ARRANGEMENT SHALL BE PROVIDED & MAINTAINED AS PER THE FACTORY ACT 1948, & RULES FRAMED THERE UNDER.
6.. SECTION CUT LINE SHOWN IN BLUE COLOR.
7.. BOUNDARY SHOWN IN GREEN COLOR.
8.. FIRE WATER PIPE LINE SHOWN IN
9.. EXTENSION SHOWN IN RED COLOR.
10. DEMOLISHED STRUCTURE SHOWN THUS

MAIN ENTRANCE DOOR = 6000 x 4500 (IRON)
MANY SMALL WINDOWS & VENTILATORS ARE COVERED WITH NET & GLASS

SILL HEIGHT = 900 mm

NAME OF THE OCCUPIER :

SIGNATURE OF THE OCCUPIER:

DATE: 29.11.2025

PROJECT : FACTORY MANUFACTURING OF FABRICATION & ENGINEERING

FACTORY PLAN OF
BRBA INFRATECH LLP

TITLE : PLAN OF SHORT BLASTING CHAMBER & OTHER STRUCTURAL DETAILS

ADDRESS : PANBARI, P.O & P.S - ALIPURDUAR, DISTRICT - ALIPURDUAR, WESTBENGAL, PIN - 736121

PREVIOUS APPROVAL PLAN NUMBER: 1947
DATE: 24/07/2024

DATE: 29.11.2025

SCALE : 1:1000

SHEET NO: 2 OF 5

N O T E S

1. 20 NOS OF LPG INDUSTRIAL CYLINDER CAPACITY 47.5 KG
2. TOTAL LPG 950 KG
ALL ELECTRICAL FITTINGS ARE FLAME PROOF.
3. PROVISION OF GAS LEAKAGE DETECTOR, FLAME ARRESTERS, AUTO WATER SPRINKLER SYSTEM, (DRY CHEMICAL POWER) FIRE EXTINGUISHER. SAND BUCKET & HYDRANT POINT.
4. OPEN OUT WARDS WIRE NET DOUBLE PANELED DOOR TOP TO BOTTOM.
5. DOUBBLE BINDING EARTHING ARRANGEMENT.
6. L.P.G. SUPPLY TO PLANT BY E.R.W PIPING AS PER (IS 1239 OR RECOMMENDED IS CODE).

STALK HEIGHT OF DG & CHIMNEY AS PER W.B.P.C.B. NORMS

NOTE FOR SHOT BLASTING
SUITABLE BLASTING ENCLOSURE, LIKE EVERY DOOR APERTURE & JOINT OF BLASTING OPERATION ALONG WITH SUITABLE VENTILATING PLAN WITH BAG FILTERING & SETTING DEVICE. **BLASTING IS DONE WITH APPROPRIATE PERSONAL PROTECTIVE EQUIPMENTS. ADEQUATE SUITABLE STORAGE FOR THE HELMETS, GAUNTLETS & OVERALL IS CONVENIENCE STORES THE OUTSIDE THE BLASTING ENCLOSURE.**

APPROPRIATE RUBBER INSULATION MAT ARRANGEMENT IN FRONT OF ALL ELECTRICAL PANEL & ENGINE & DG ROOM.

LIQUEFIED PETROLEUM GAS DETECTING SENSOR & ALARM ARRANGEMENT INSTALLED IN ALL VULNERABLE ZONE.

TOTAL Nos OF INDUSTRIAL LPG CYLINDER FOR INDUSTRIAL USED 20 Nos @ 45.7 kg CAPACITY PER CYLINDER.