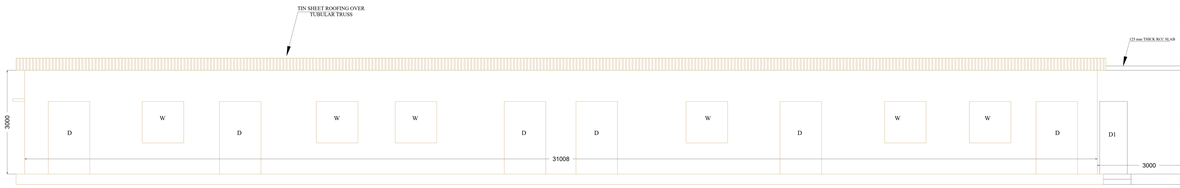

FRONT OF STORE ROOM, IN SITE PLAN SHOWN
IN DEMOLISHED STRUCTURE
SCALE 1:1000

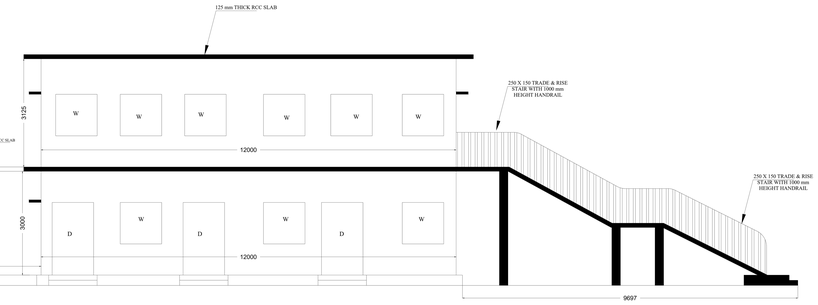

FRONT ELEVATION OF ELECTRICAL STORE ROOM,
AS PER SITE PLAN ITEM NUMBER 6,
SCALE 1:1000

FRONT ELEVATION OF MALE LATRINE & URINAL
BLOCK 1, AS PER SITE PLAN ITEM NUMBER 5
SCALE 1:1000

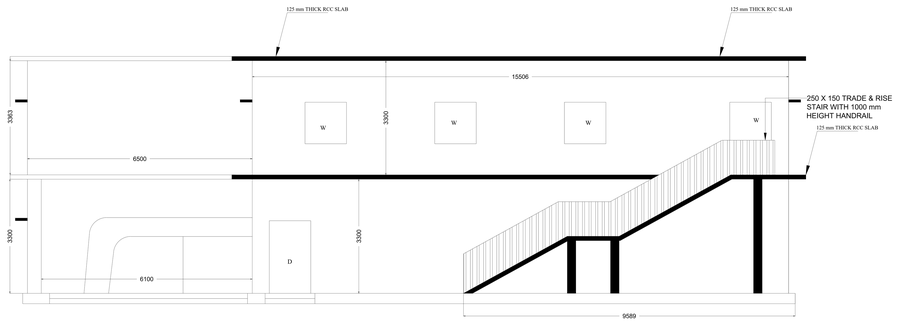

NORTH ELEVATION OF STORE ROOM & PERSONAL
PROTECTIVE EQUIPMENT STORE ROOM & SHOT
BLASTING CHAMBER, AS PER SITE PLAN ITEM
NUMBER 11
SCALE 1:1000

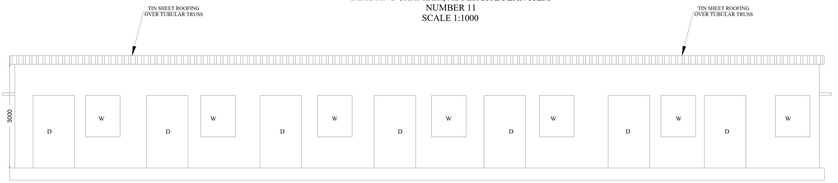

NORTH ELEVATION OF STORE ROOM 2, AS PER
SITE PLAN ITEM NUMBER 12
SCALE 1:1000

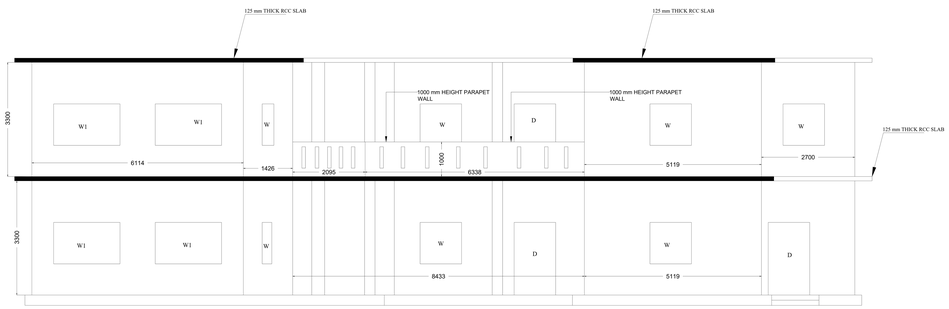

FRONT ELEVATION OF OFFICE
BUILDING, AS PER SITE PLAN ITEM
NUMBER 8
SCALE 1:1000

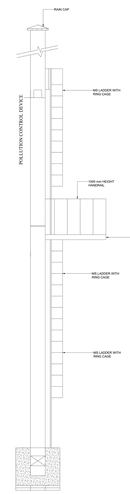

SECTION OF SELF SUPPORTED
SMOKE CHIMNEY
N.T.S.

PLAN OF SELF SUPPORTED
SMOKE CHIMNEY
N.T.S.

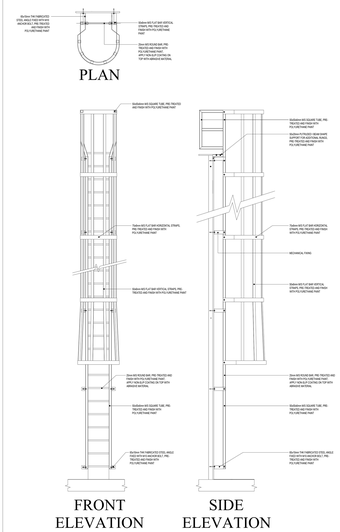

PLAN & ELEVATION OF RING CAGE
LADDER
NOT TO SCALE

APPROPRIATE RUBBER INSULATION MAT
ARRANGEMENT IN FRONT OF ALL
ELECTRICAL PANEL & ENGINE & DG ROOM.

SCHEDULE OF DOOR & WINDOW

SIGN	WIDTH	HEIGHT	SILL HEIGHT
W	1200	1200	900
W1	2000	1200	900
V	300	150	2350
D	1200	2100	-
D1	800	2100	-
D2	3000	2300	-

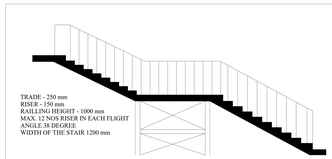

DETAILED OF
STAIR N.T.S.

NOTES:

1.... Total nos of workers including office staff - 85 Nos (Male only)
2.... ALL DIMENSIONS ARE IN mm. UNLESS OTHERWISE MENTIONED.
3.... Total no of latrine and urinal :
For male : Latrine 4 nos, Urinal 4 nos.
4.... All doors & windows are opening outwards.
5.... POSITION OF FIRST AID, FIRE FIGHTING ARRANGEMENT SHALL BE PROVIDED & MAINTAINED AS PER THE FACTORY ACT 1948, & RULES FRAMED THERE UNDER.
6.... SECTION CUT LINE SHOWN IN BLUE COLOR
7.... BOUNDARY SHOWN IN GREEN COLOR.
8.... FIRE WATER PIPE LINE SHOWN IN
9.... EXTENSION SHOWN IN RED COLOR.
10.. DEMOLISHED STRUCTURE SHOWN THUS

MAIN ENTRANCE DOOR = 6000 x 4500 (IRON)
MANY SMALL WINDOWS & VENTILATORS ARE COVERED WITH NET & GLASS

SILL HEIGHT = 900 mm

NAME OF THE OCCUPIER :

SIGNATURE OF THE OCCUPIER:

DATE: 29.11.2025

PROJECT : FACTORY MANUFACTURING OF FABRICATION & ENGINEERING

FACTORY PLAN OF
BRBA INFRATECH LLP

TITLE : FRONT ELEVATION OF OFFICE &
OTHER STRUCTURAL DETAILS

ADDRESS : PANBARI, P.O & P.S - ALIPURDUAR,
DISTRICT - ALIPURDUAR, WESTBENGAL, PIN - 736121

PREVIOUS APPROVAL PLAN NUMBER:1947
DATE: 24/07/2024

DATE: 29.11.2025

SCALE : 1:1000

SHEET NO: 4 OF 5