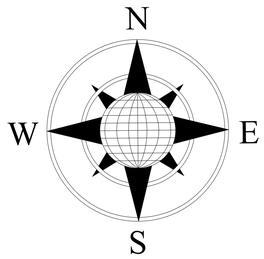

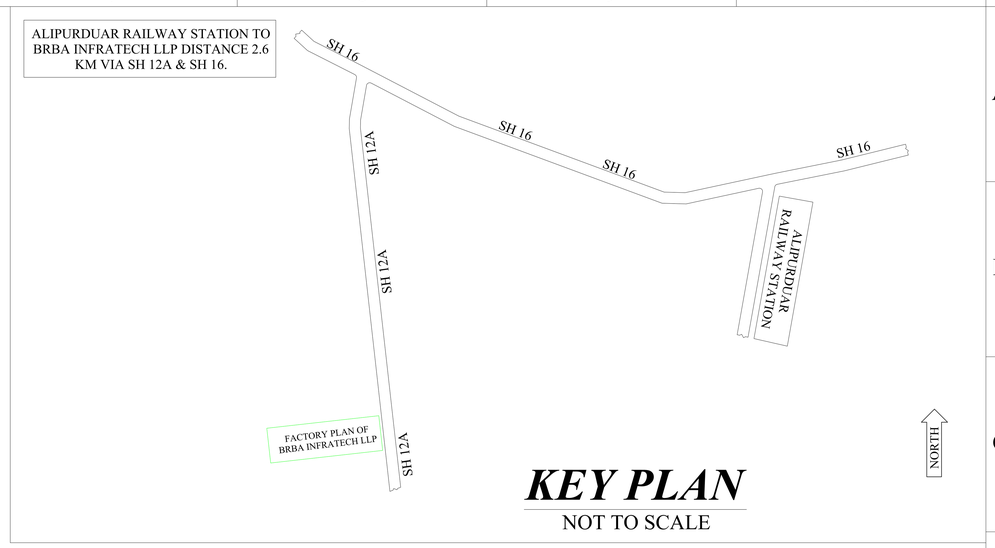

KEY PLAN

NOT TO SCALE

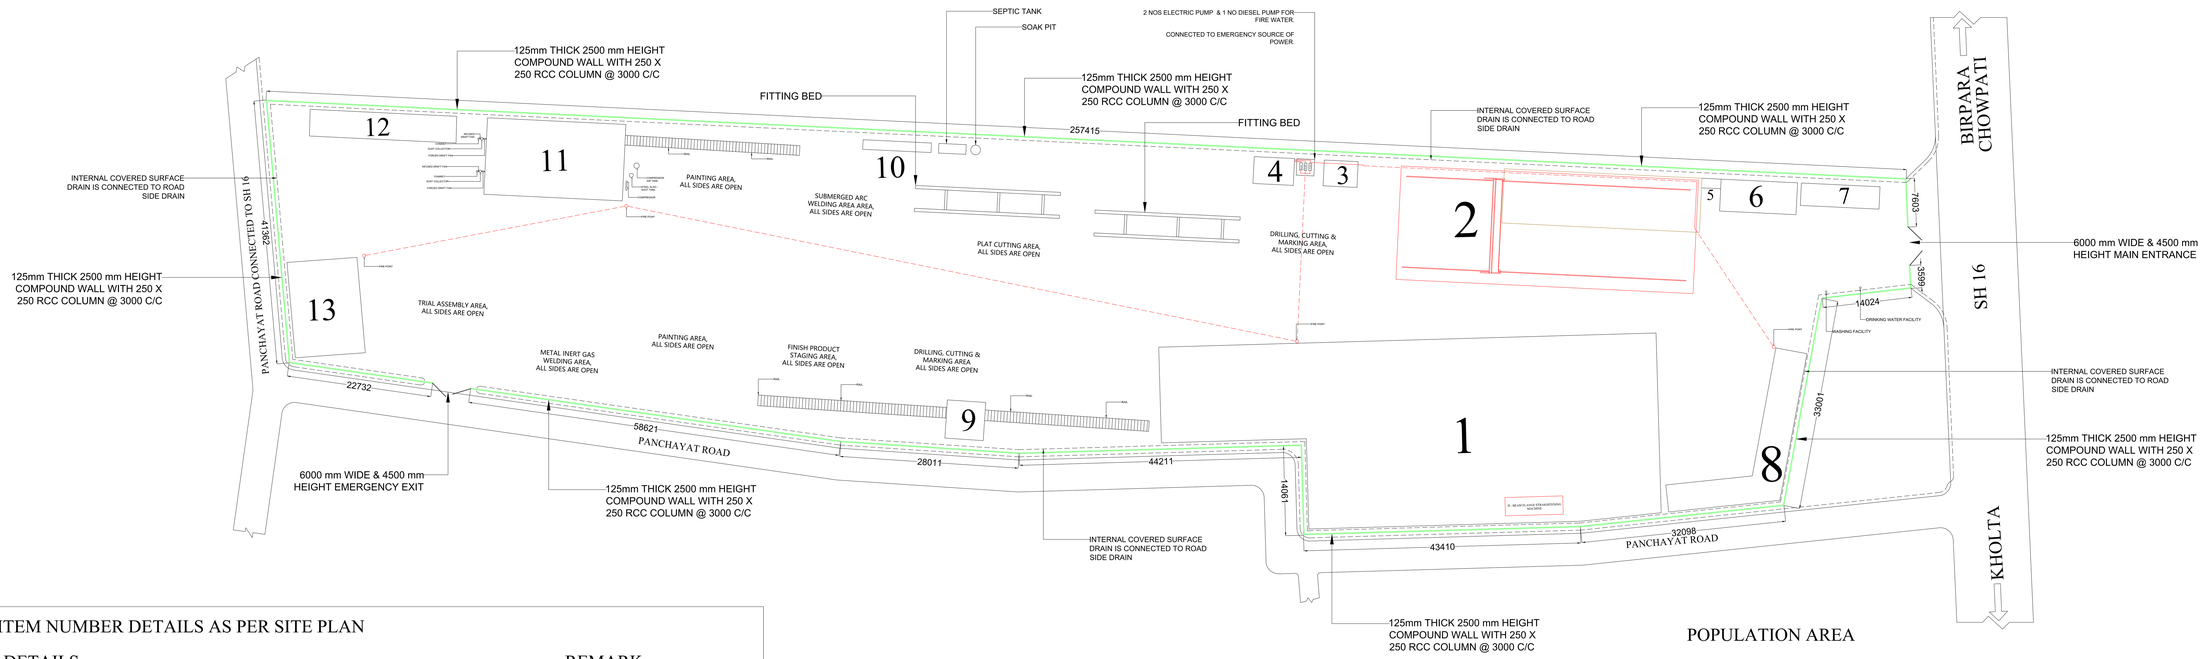

SCHEDULE OF ITEM NUMBER DETAILS AS PER SITE PLAN		
ITEM NO	DETAILS	REMARK
1	WELDING AREA, COMPRESSOR, FITTING & LAYOUT BED & OTHER ENGINEERING WORKS SHED	ALREADY APPROVED
2	FITTING & LAYOUT BED SHED	APPROVAL NEEDED
3	LIQUEFIED PETROLEUM GAS BANK	ALREADY APPROVED
4	UNDERGROUND FIRE WATER RESERVOIR 200000 LTR CAPACITY & FIRE WATER PUMP ROOM	ALREADY APPROVED
5	MALE LATRINE & URINAL BLOCK 1	ALREADY APPROVED
6	ELECTRICAL ROOM & STORE ROOM	ALREADY APPROVED
7	CYCLE PARKING SHED	ALREADY APPROVED
8	OFFICE & STAFF REST ROOM & STORE ROOM	ALREADY APPROVED
9	DRILL MACHINE SHED	ALREADY APPROVED
10	MALE LATRINE & URINAL BLOCK 2	ALREADY APPROVED
11	SHOT BLASTING CHAMBER & STORE ROOM	ALREADY APPROVED
12	STORE ROOM 2	ALREADY APPROVED
13	VEHICLE GARAGE SHED	ALREADY APPROVED

SITE PLAN

SCALE 1:1000

OPERATIONAL SAFETY

1. ONLY TRAINED AND AUTHORIZED PERSONNEL SHOULD OPERATE SHOT BLASTING MACHINERY.

2. CONDUCT PRE-OPERATION CHECKS FOR NOZZLE INTEGRITY, HOSE CONNECTIONS, AND EQUIPMENT SETTINGS.

3. ENSURE EMERGENCY STOP BUTTONS AND ALARMS ARE FUNCTIONAL AND ACCESSIBLE.

4. PROHIBIT ENTRY INTO THE BLAST CHAMBER WHILE EQUIPMENT IS IN OPERATION.

WORK ENVIRONMENT

1. MAINTAIN CLEAN AND ORGANIZED WORK AREAS TO PREVENT TRIPPING HAZARDS AND ABRASIVE ACCUMULATION.

2. REGULARLY REMOVE SPENT ABRASIVES AND WASTE MATERIALS IN COMPLIANCE WITH ENVIRONMENTAL REGULATIONS.

3. CLEARLY MARK HAZARD ZONES AND RESTRICT UNAUTHORIZED ACCESS.

EMERGENCY PREPAREDNESS

1. EQUIP THE FACILITY WITH APPROPRIATE FIRE EXTINGUISHERS, FIRST AID KITS, AND SPILL CONTAINMENT SYSTEMS.

2. ESTABLISH AND COMMUNICATE EMERGENCY RESPONSE PROCEDURES FOR INJURIES, FIRES, AND EQUIPMENT FAILURES.

3. MAINTAIN A REGISTER OF MATERIAL SAFETY DATA SHEETS (M.S.D.S.) FOR ALL MATERIALS AND ABRASIVES USED.

ALL REINFORCED CEMENT CONCRETE (RCC) STRUCTURES ARE DESIGNED IN ACCORDANCE WITH THE PROVISIONS AND GUIDELINES STIPULATED IN IS 456:2000, 'PLAIN AND REINFORCED CONCRETE – CODE OF PRACTICE', AS ISSUED BY THE BUREAU OF INDIAN STANDARDS (BIS).

ALL STEEL STRUCTURES ARE DESIGNED IN ACCORDANCE WITH THE PROVISIONS OF IS 800:2007, "GENERAL CONSTRUCTION IN STEEL – CODE OF PRACTICE."

DETAILS OF LAND
J.L. NO - 85, KHATIAN NO - 2111,
PLOT NO - 5441, 5442, 5443, 5445

NOTES:

1.... Total nos of workers including office staff - 85 Nos (Male only)
2.... ALL DIMENSIONS ARE IN mm. UNLESS OTHERWISE MENTIONED.
3.... Total no of latrine and urinal :
For male : Latrine 4 nos, Urinal 4 nos.
4.... All doors & windows are opening outwards.
5.... POSITION OF FIRST AID, FIRE FIGHTING ARRANGEMENT SHALL BE PROVIDED & MAINTAINED AS PER THE FACTORY ACT 1948,. & RULES FRAMED THERE UNDER.
6.... SECTION CUT LINE SHOWN IN BLUE COLOR
7.... BOUNDARY SHOWN IN GREEN COLOR.
8.... FIRE WATER PIPE LINE SHOWN IN - - - - - - - - -
9.... EXTENSION SHOWN IN RED COLOR.
10. DEMOLISHED STRUCTURE SHOWN THUS

MAIN ENTRANCE DOOR = 6000 x 4500 (IRON)
MANY SMALL WINDOWS & VENTILATORS ARE COVERED WITH NET & GLASS

SILL HEIGHT = 900 mm

NAME OF THE OCCUPIER :
SIGNATURE OF THE OCCUPIER:
DATE: 29.11.2025

PROJECT : FACTORY MANUFACTURING OF FABRICATION & ENGINEERING

FACTORY PLAN OF
BRBA INFRATECH LLP

TITLE : SITE PLAN &
KEY PLAN

ADDRESS : PANBARI, P.O & P.S - ALIPURDUAR,
DISTRICT - ALIPURDUAR, WESTBENGAL, PIN - 736121

PREVIOUS APPROVAL PLAN NUMBER: 1947
DATE: 24/07/2024

DATE: 29.11.2025
SCALE : 1:1000

SHEET NO: 1 OF 5